




0640 BDD 018

-Green shaded area is limit of maintenance work area.

-Ensure outfall area is maintained.

-Access VIA roadway shoulder.

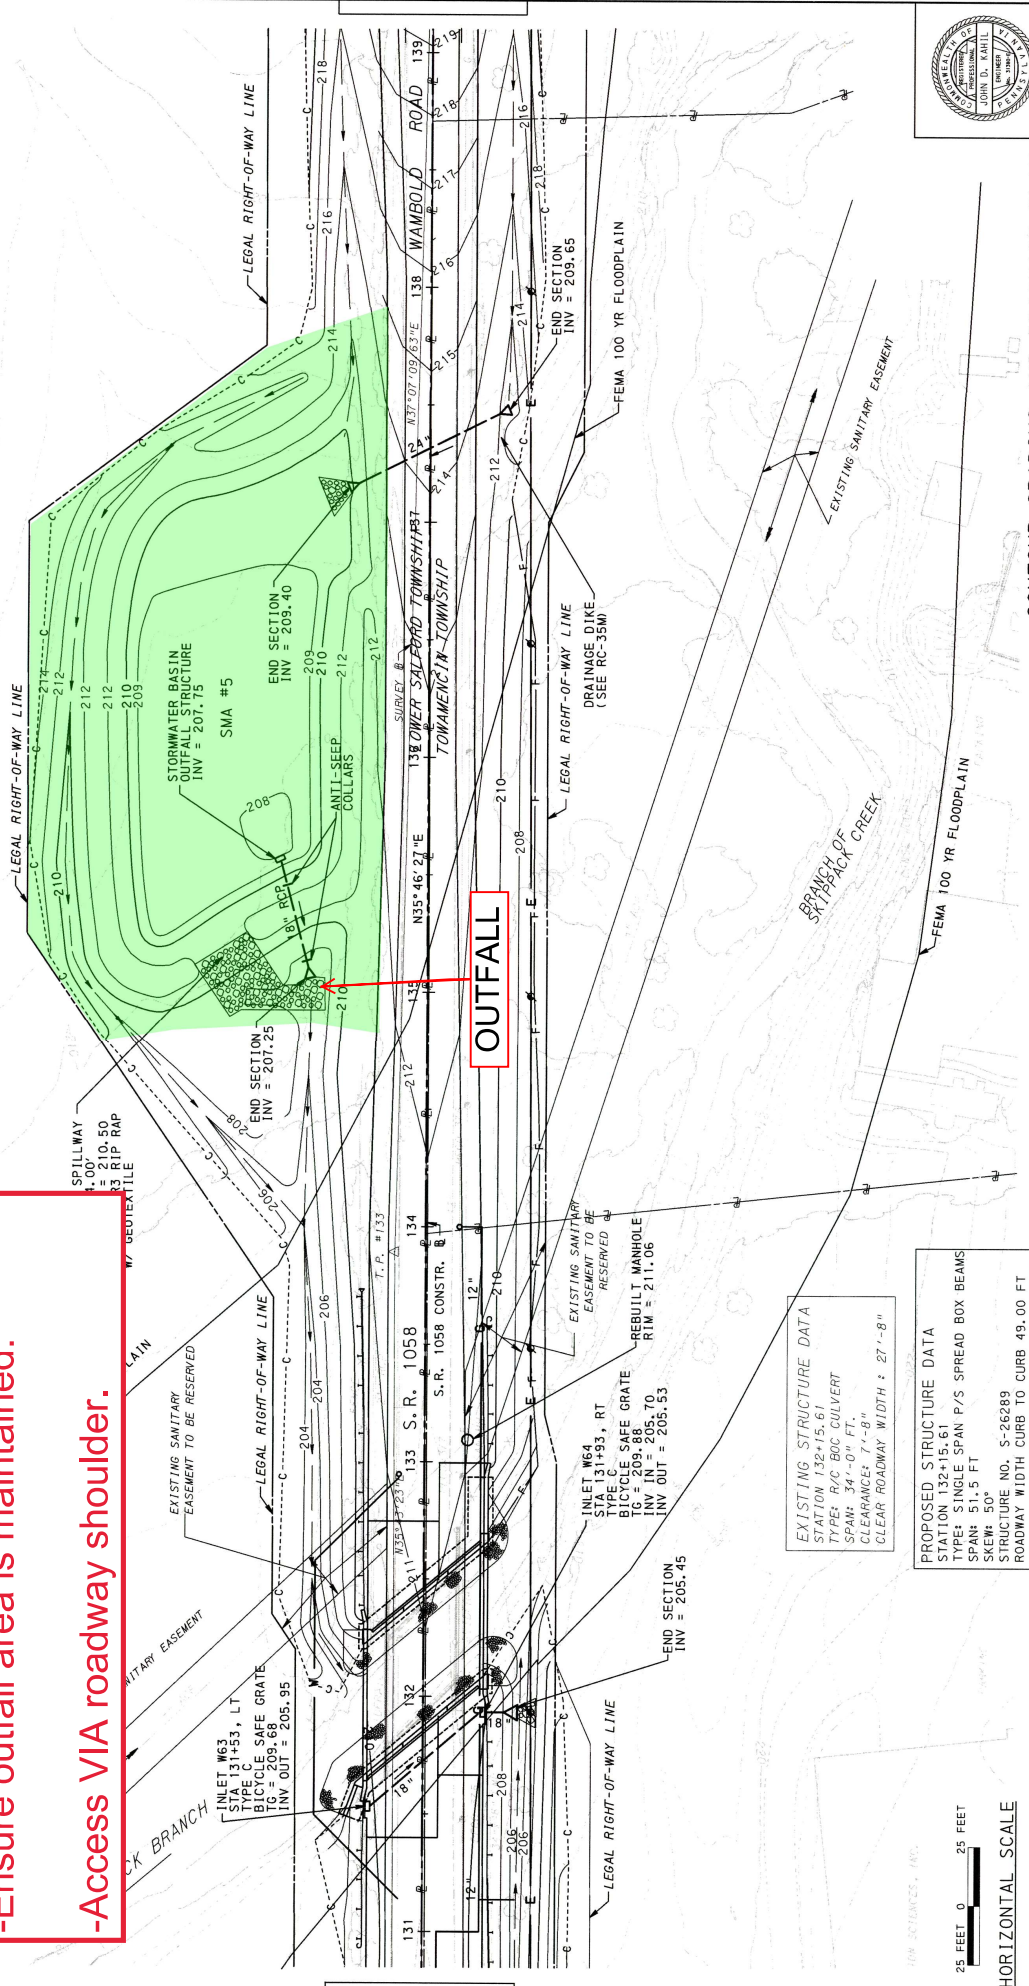

EXISTING STRUCTURE DATA  
 STATION 132+15.61  
 TYPE: R/C BOC CULVERT  
 SPAN: 34'-0" FT.  
 CLEARANCE: 7'-8"  
 CLEAR ROADWAY WIDTH: 27'-8"


PROPOSED STRUCTURE DATA  
 STATION 132+15.61  
 TYPE: SINGLE SPAN P/S SPREAD BOX BEAMS  
 SPAN: 51.5 FT  
 SKEW: 50°  
 STRUCTURE NO. S-26289  
 ROADWAY WIDTH CURB TO CURB: 49.00 FT




CONTOUR GRADING AND DRAINAGE PLAN





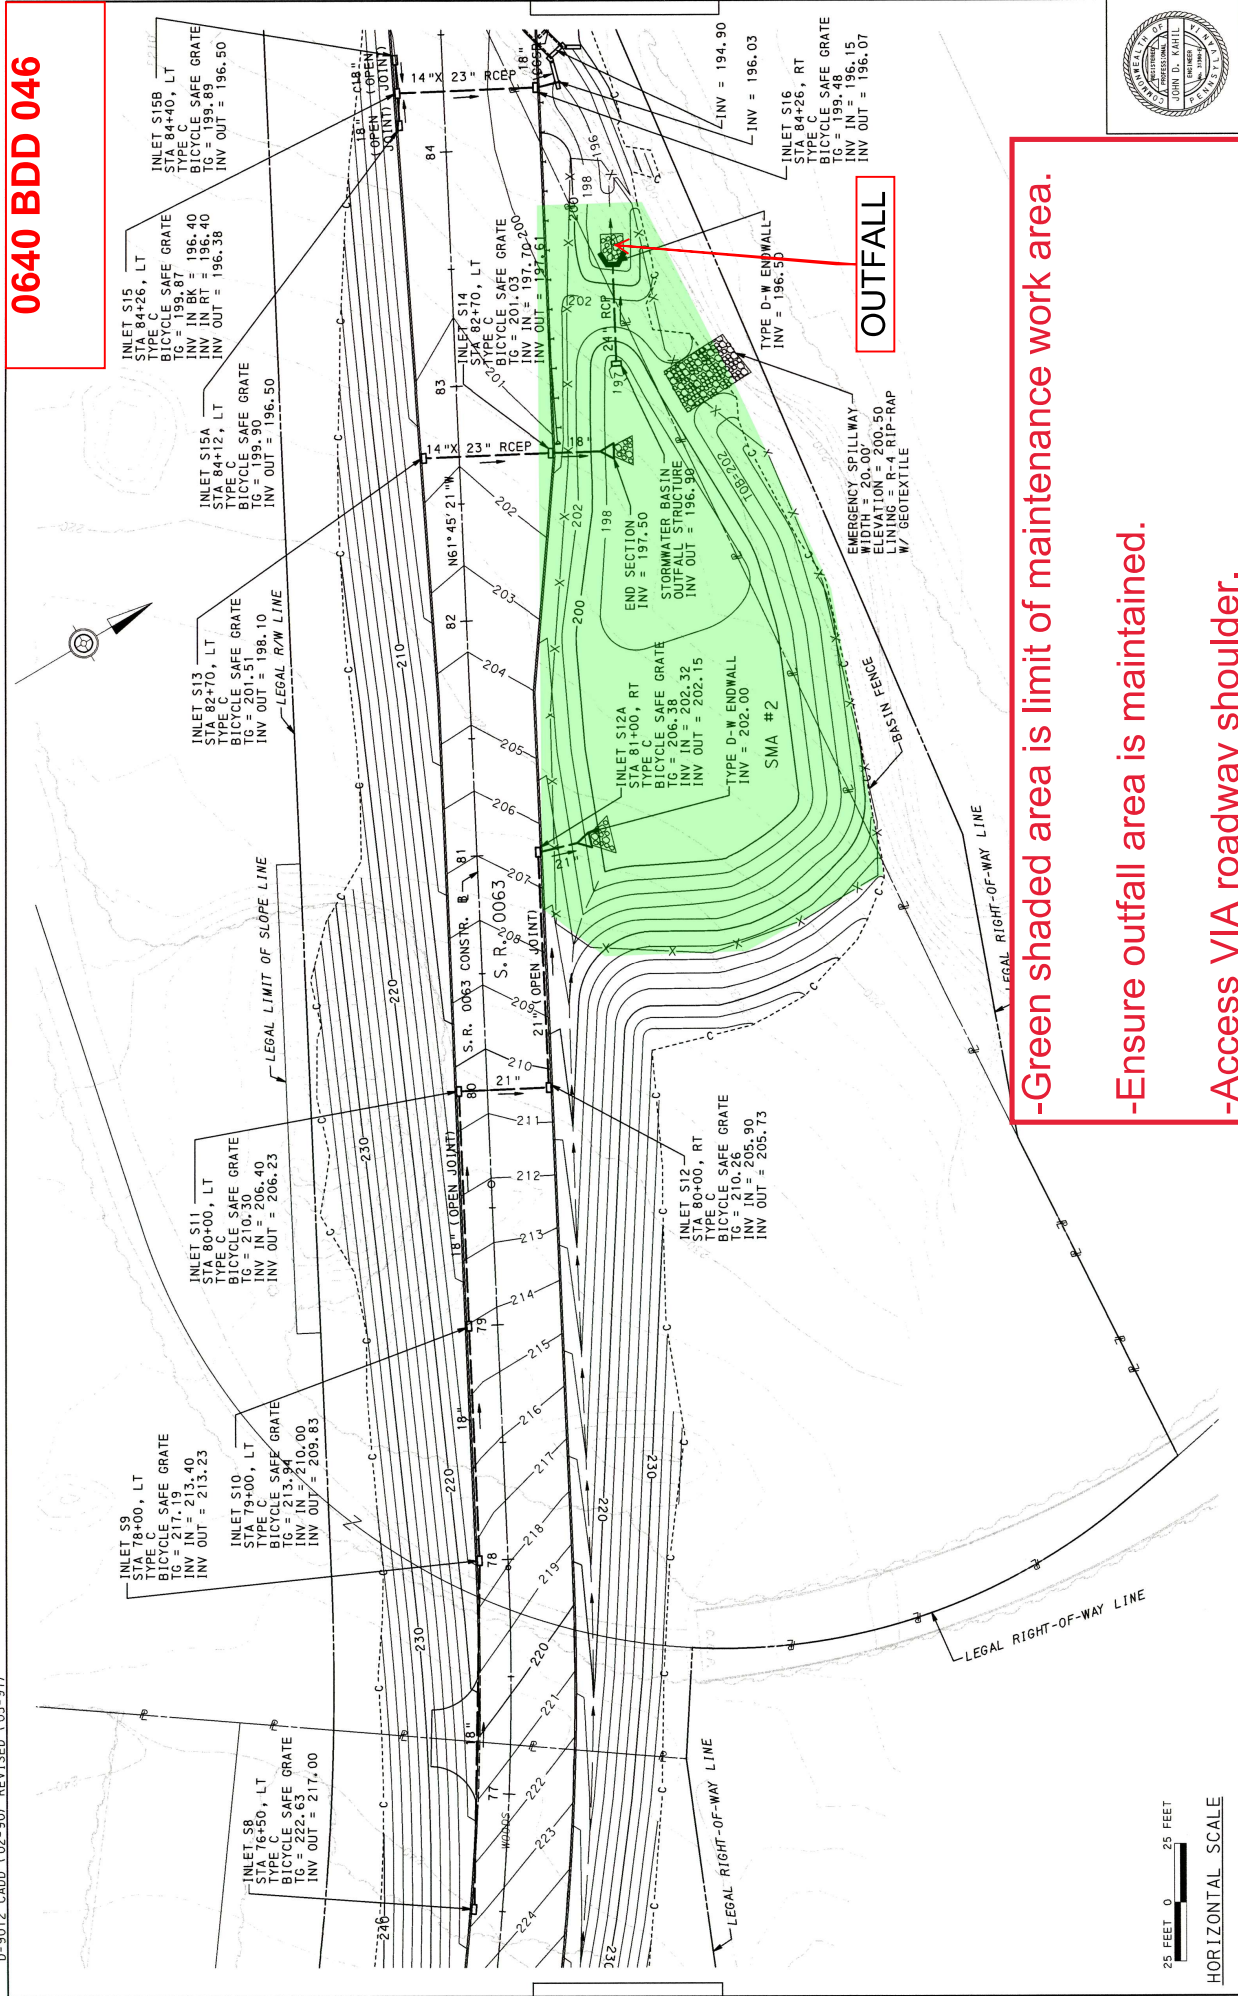



- Green shaded area is limit of maintenance work area.
- Ensure outfall area is maintained.
- Access VIA roadway shoulder.

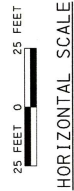



**0640 BDD 064**

BM #2124 ELEV. 226.67 SURVEY CENTERLINE S.R. 0076  
38.93' LT. STA. 22+60.75  
IRON PIN

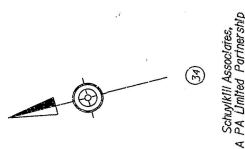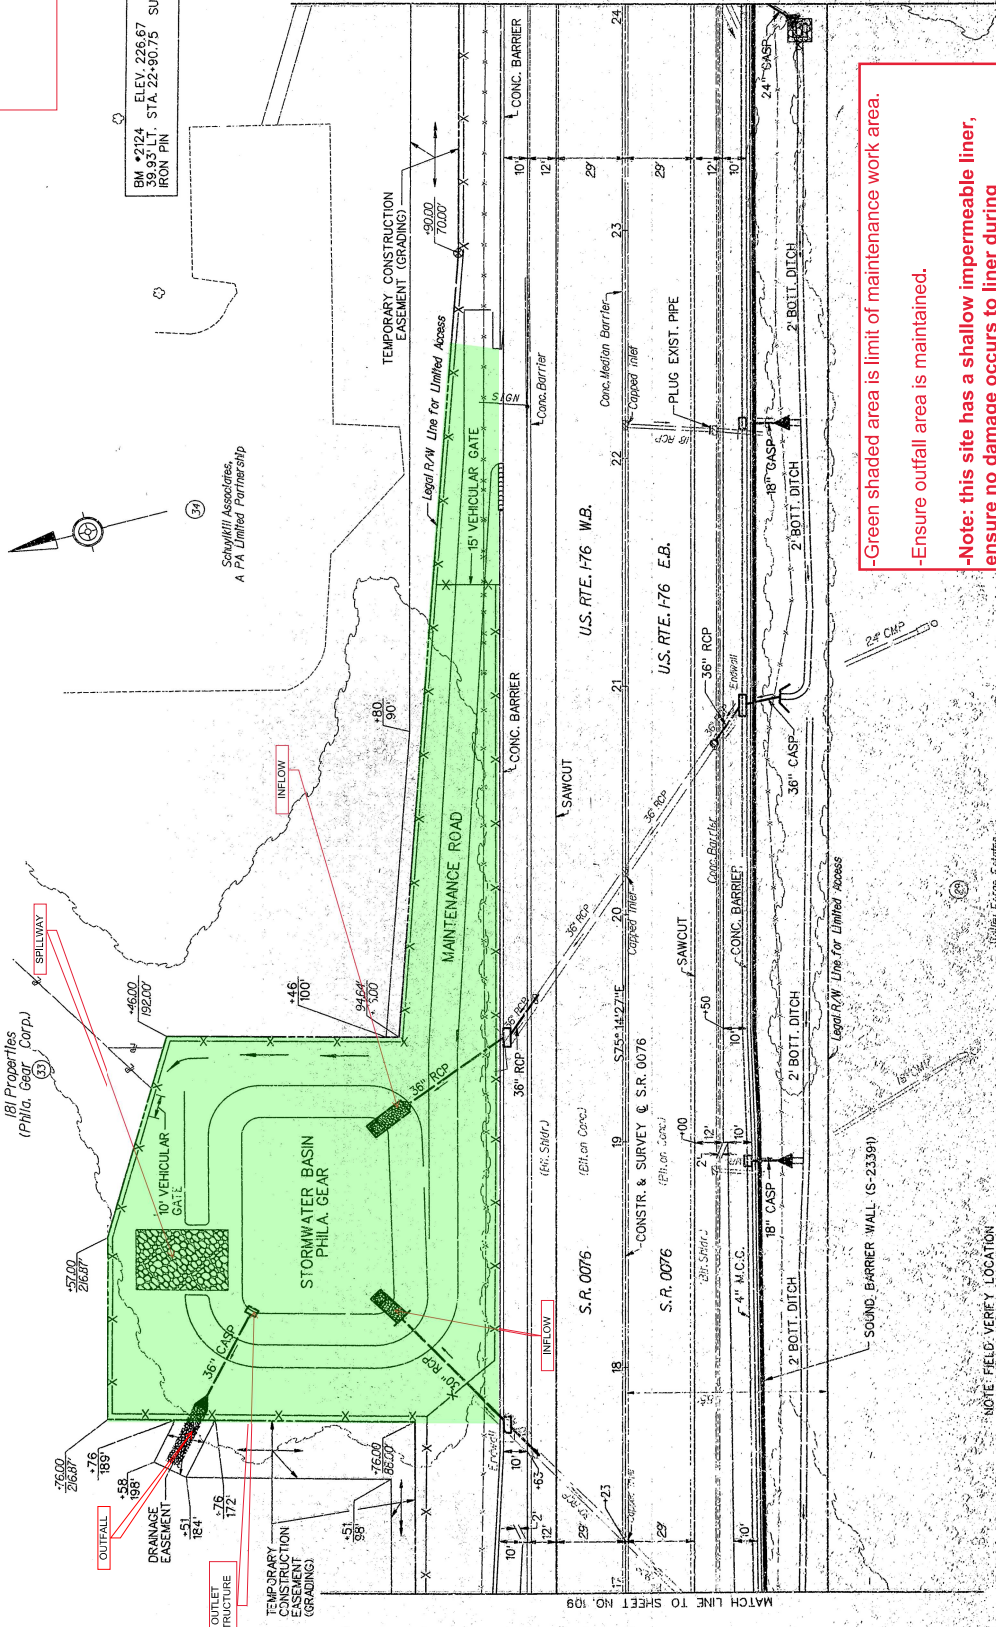

- Green shaded area is limit of maintenance work area.
- Ensure outfall area is maintained.
- Note: this site has a shallow impermeable liner, ensure no damage occurs to liner during maintenance activities.
- Access VIA roadway shoulder.

NOTE RE: VERIFY LOCATION OF EXISTING CONCRETE BASE COURSE PRIOR TO SAW CUTTING.



SURVEY INC. NO. 155

MATCH LINE TO SHEET NO. 111


MATCH LINE TO SHEET NO. 109







0640 BID 019

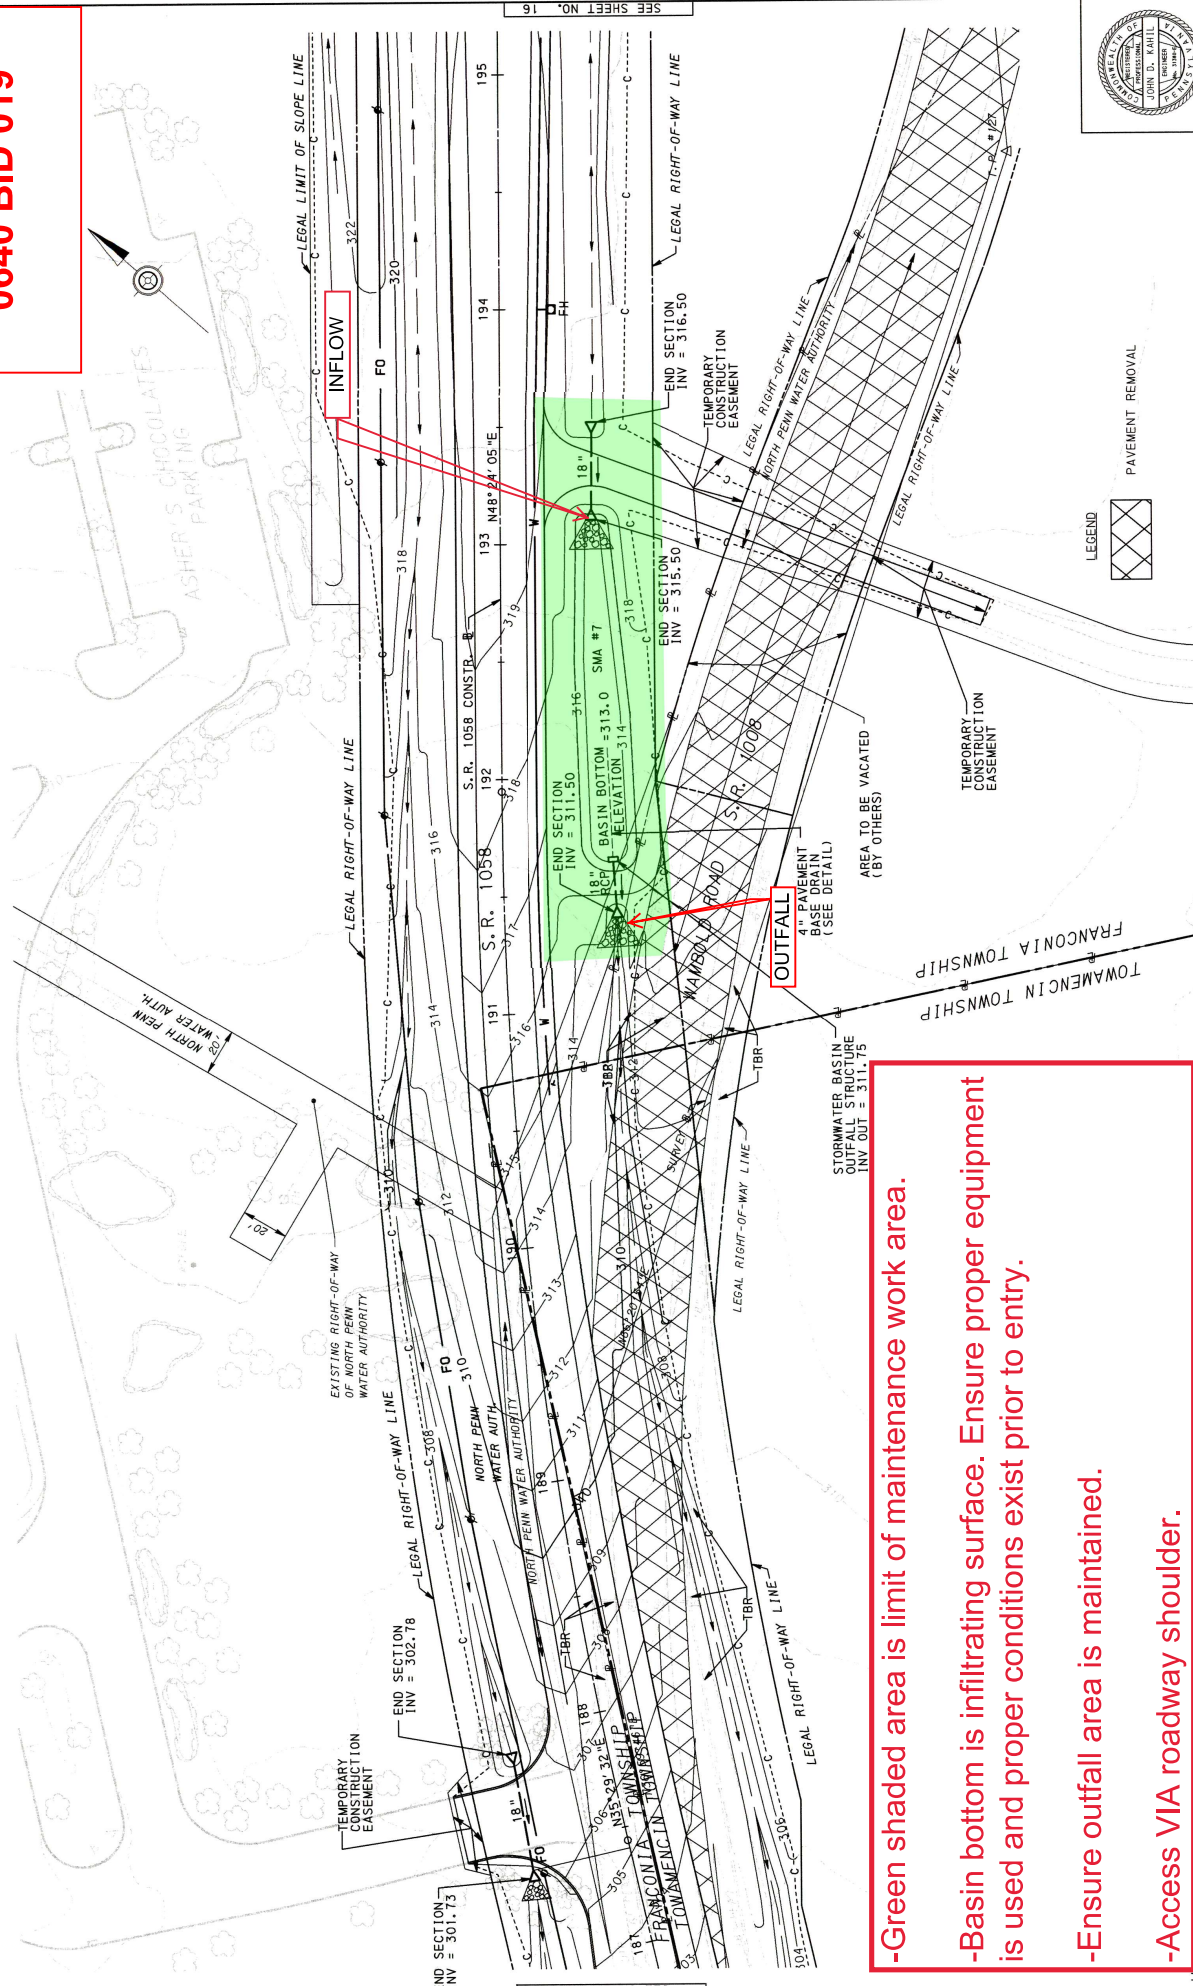

**-Green shaded area is limit of maintenance work area.**

**-Basin bottom is infiltrating surface. Ensure proper equipment is used and proper conditions exist prior to entry.**

**-Ensure outfall area is maintained.**

**-Access VIA roadway shoulder.**



HORIZONTAL SCALE

CONTOUR GRADING AND DRAINAGE PLAN



SEE SHEET NO. 14

SEE SHEET NO. 16













**0640 BRE Pond 3**  
**0640 BRU Pond 4**  
**0640 BRE Pond 5**

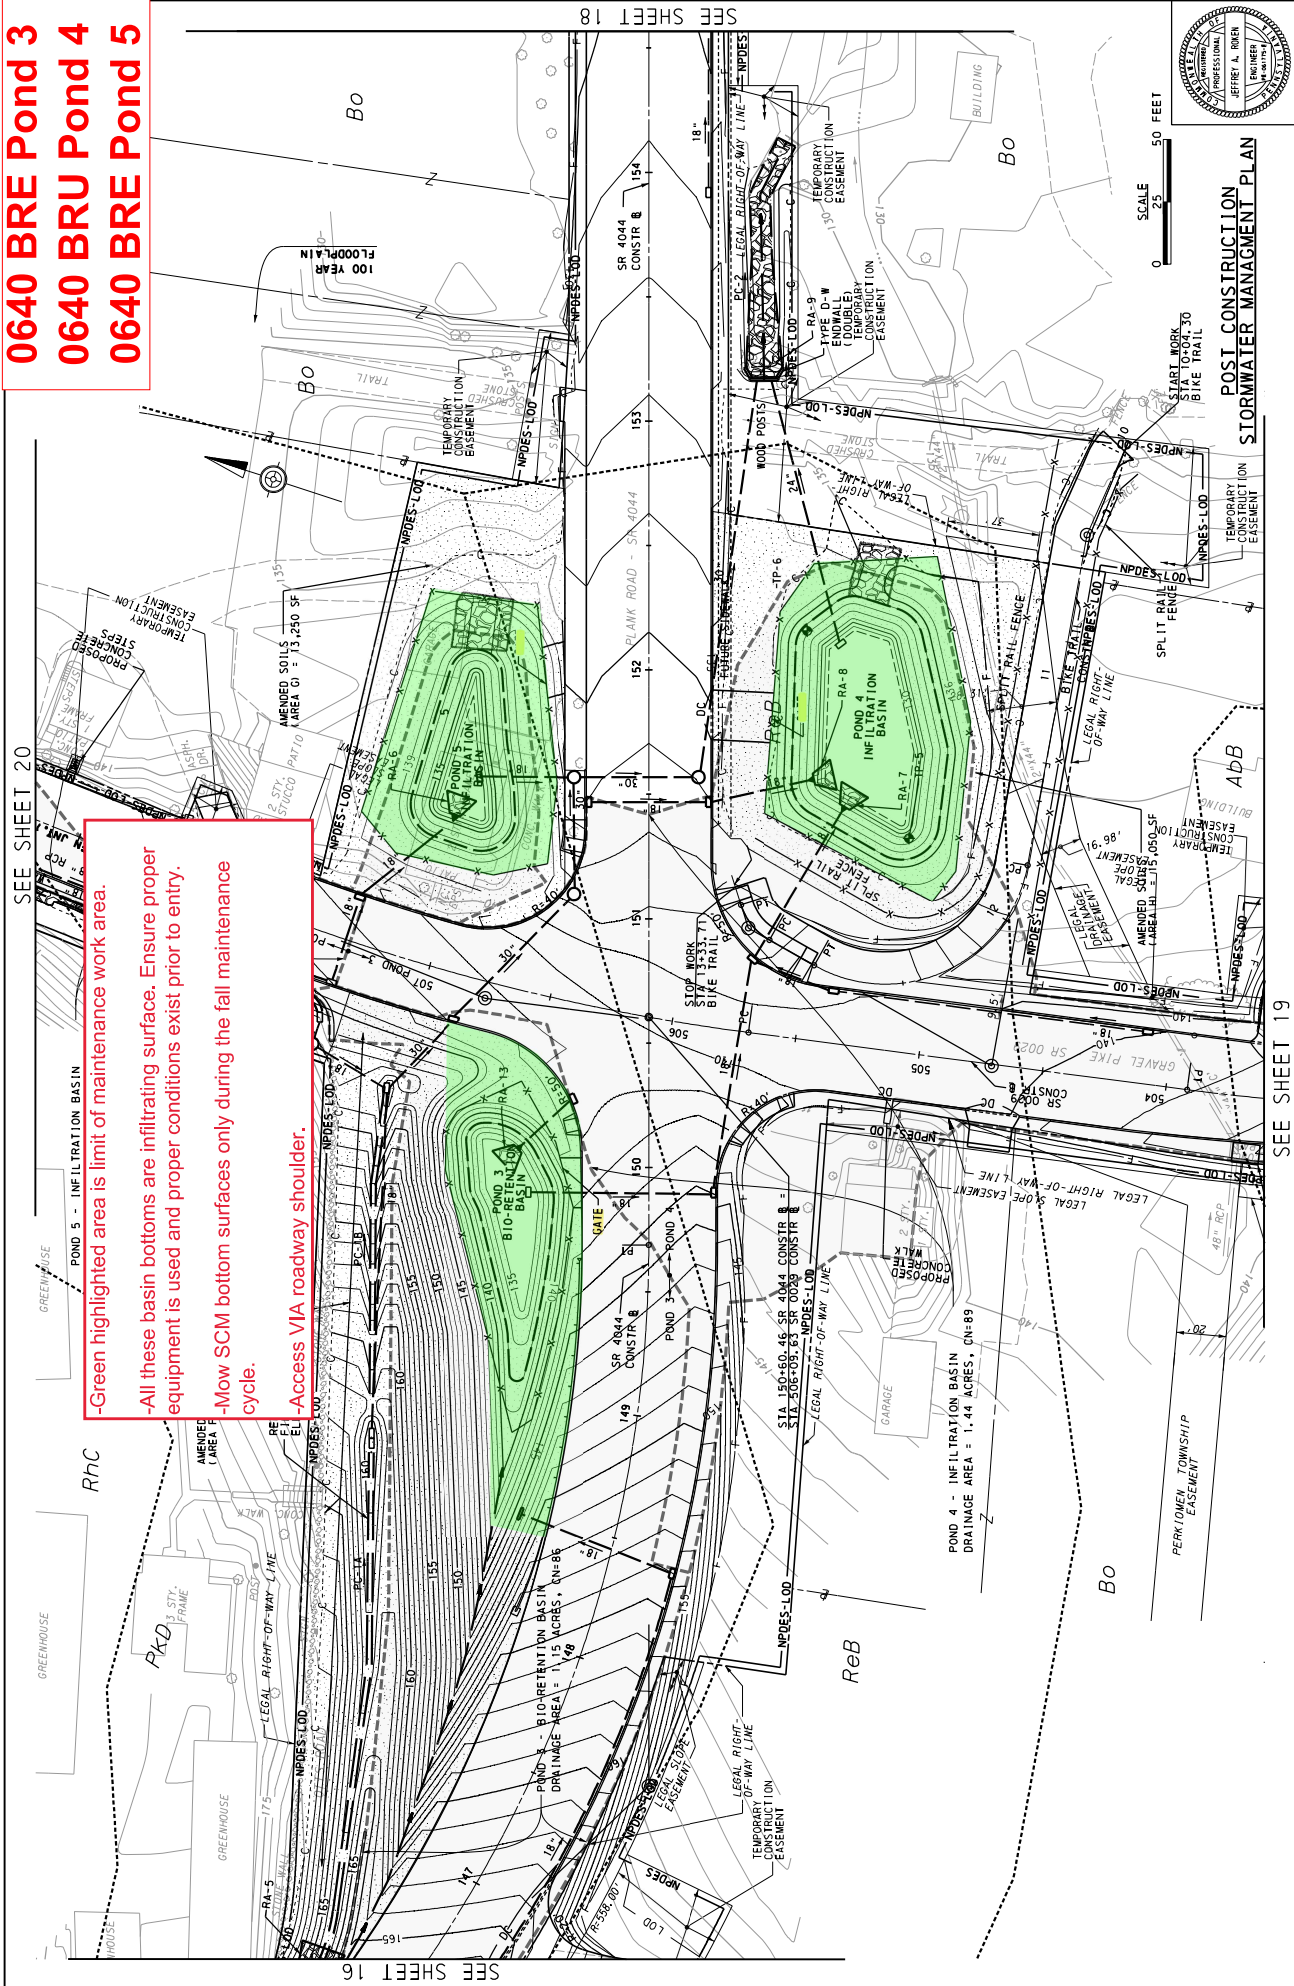

-Green highlighted area is limit of maintenance work area.  
 -All these basin bottoms are infiltrating surface. Ensure proper equipment is used and proper conditions exist prior to entry.  
 -Mow SCM bottom surfaces only during the fall maintenance cycle.  
 -Access VIA roadway shoulder.

SEE SHEET 20

SEE SHEET 18

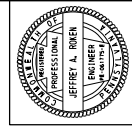


**POST CONSTRUCTION  
 STORMWATER MANAGEMENT PLAN**






**0640 SDS 001**

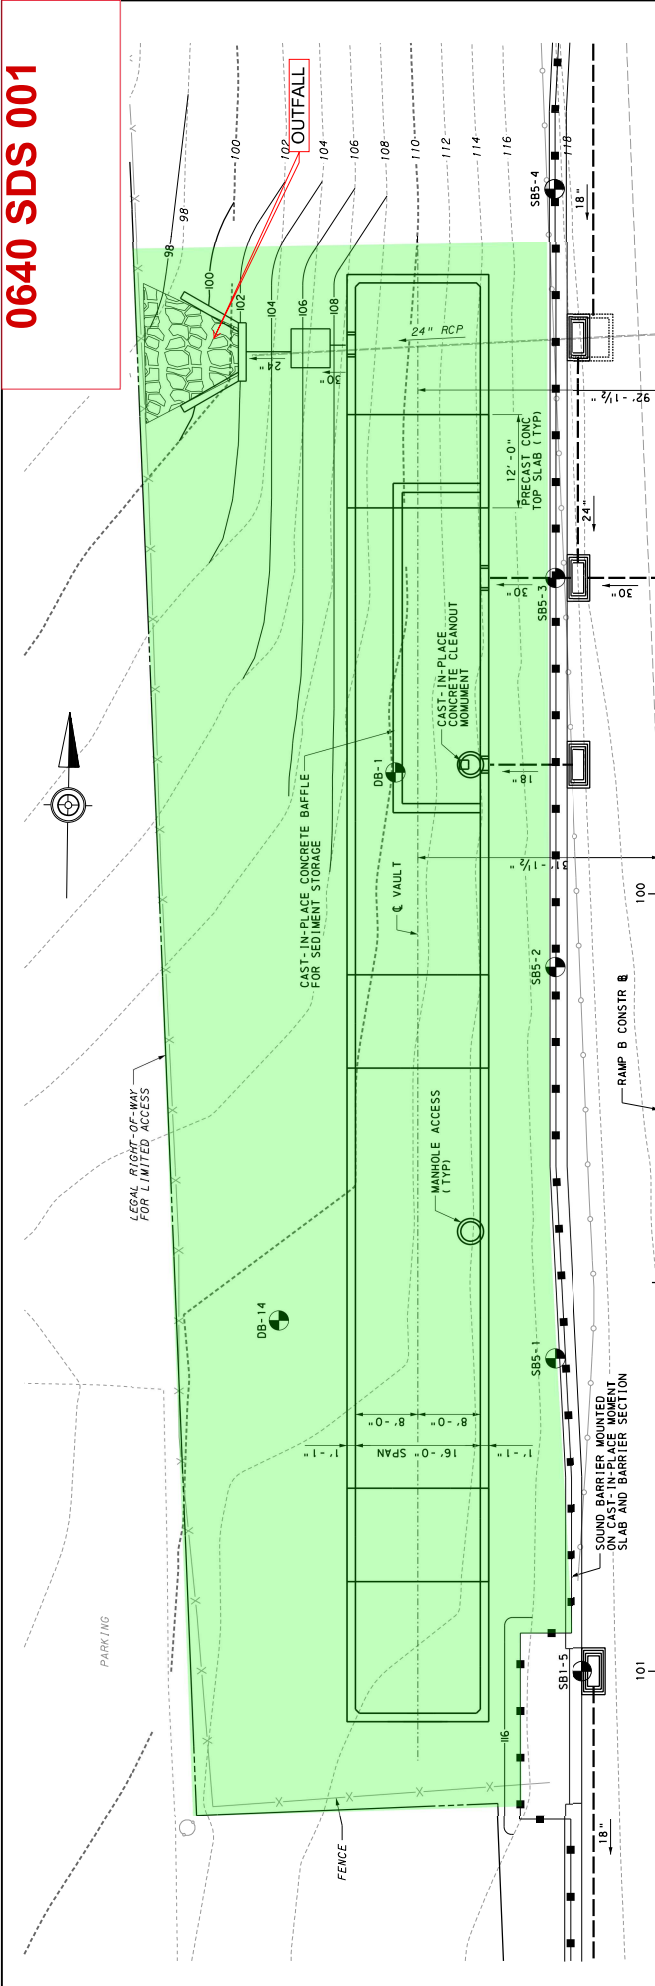

-Green highlighted area is limit of maintenance work area.  
 -Note this is a subsurface feature. For trash and debris removal focus on outflow area.  
 -Ensure outfall area is maintained.

**PLAN**

2" = 48 FEET

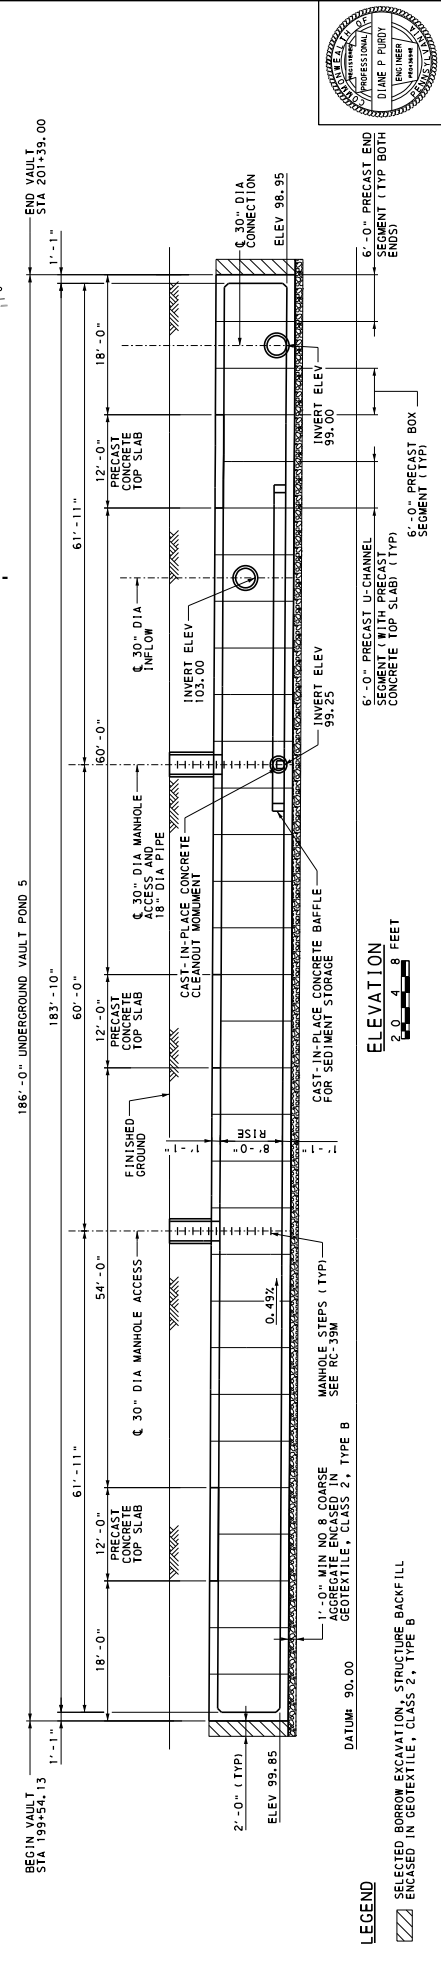

**ELEVATION**

2" = 4 FEET

**LEGEND**

- SELECTED BORROW EXCAVATION, STRUCTURE BACKFILL ENCASED IN GEOTEXTILE, CLASS C, TYPE B

